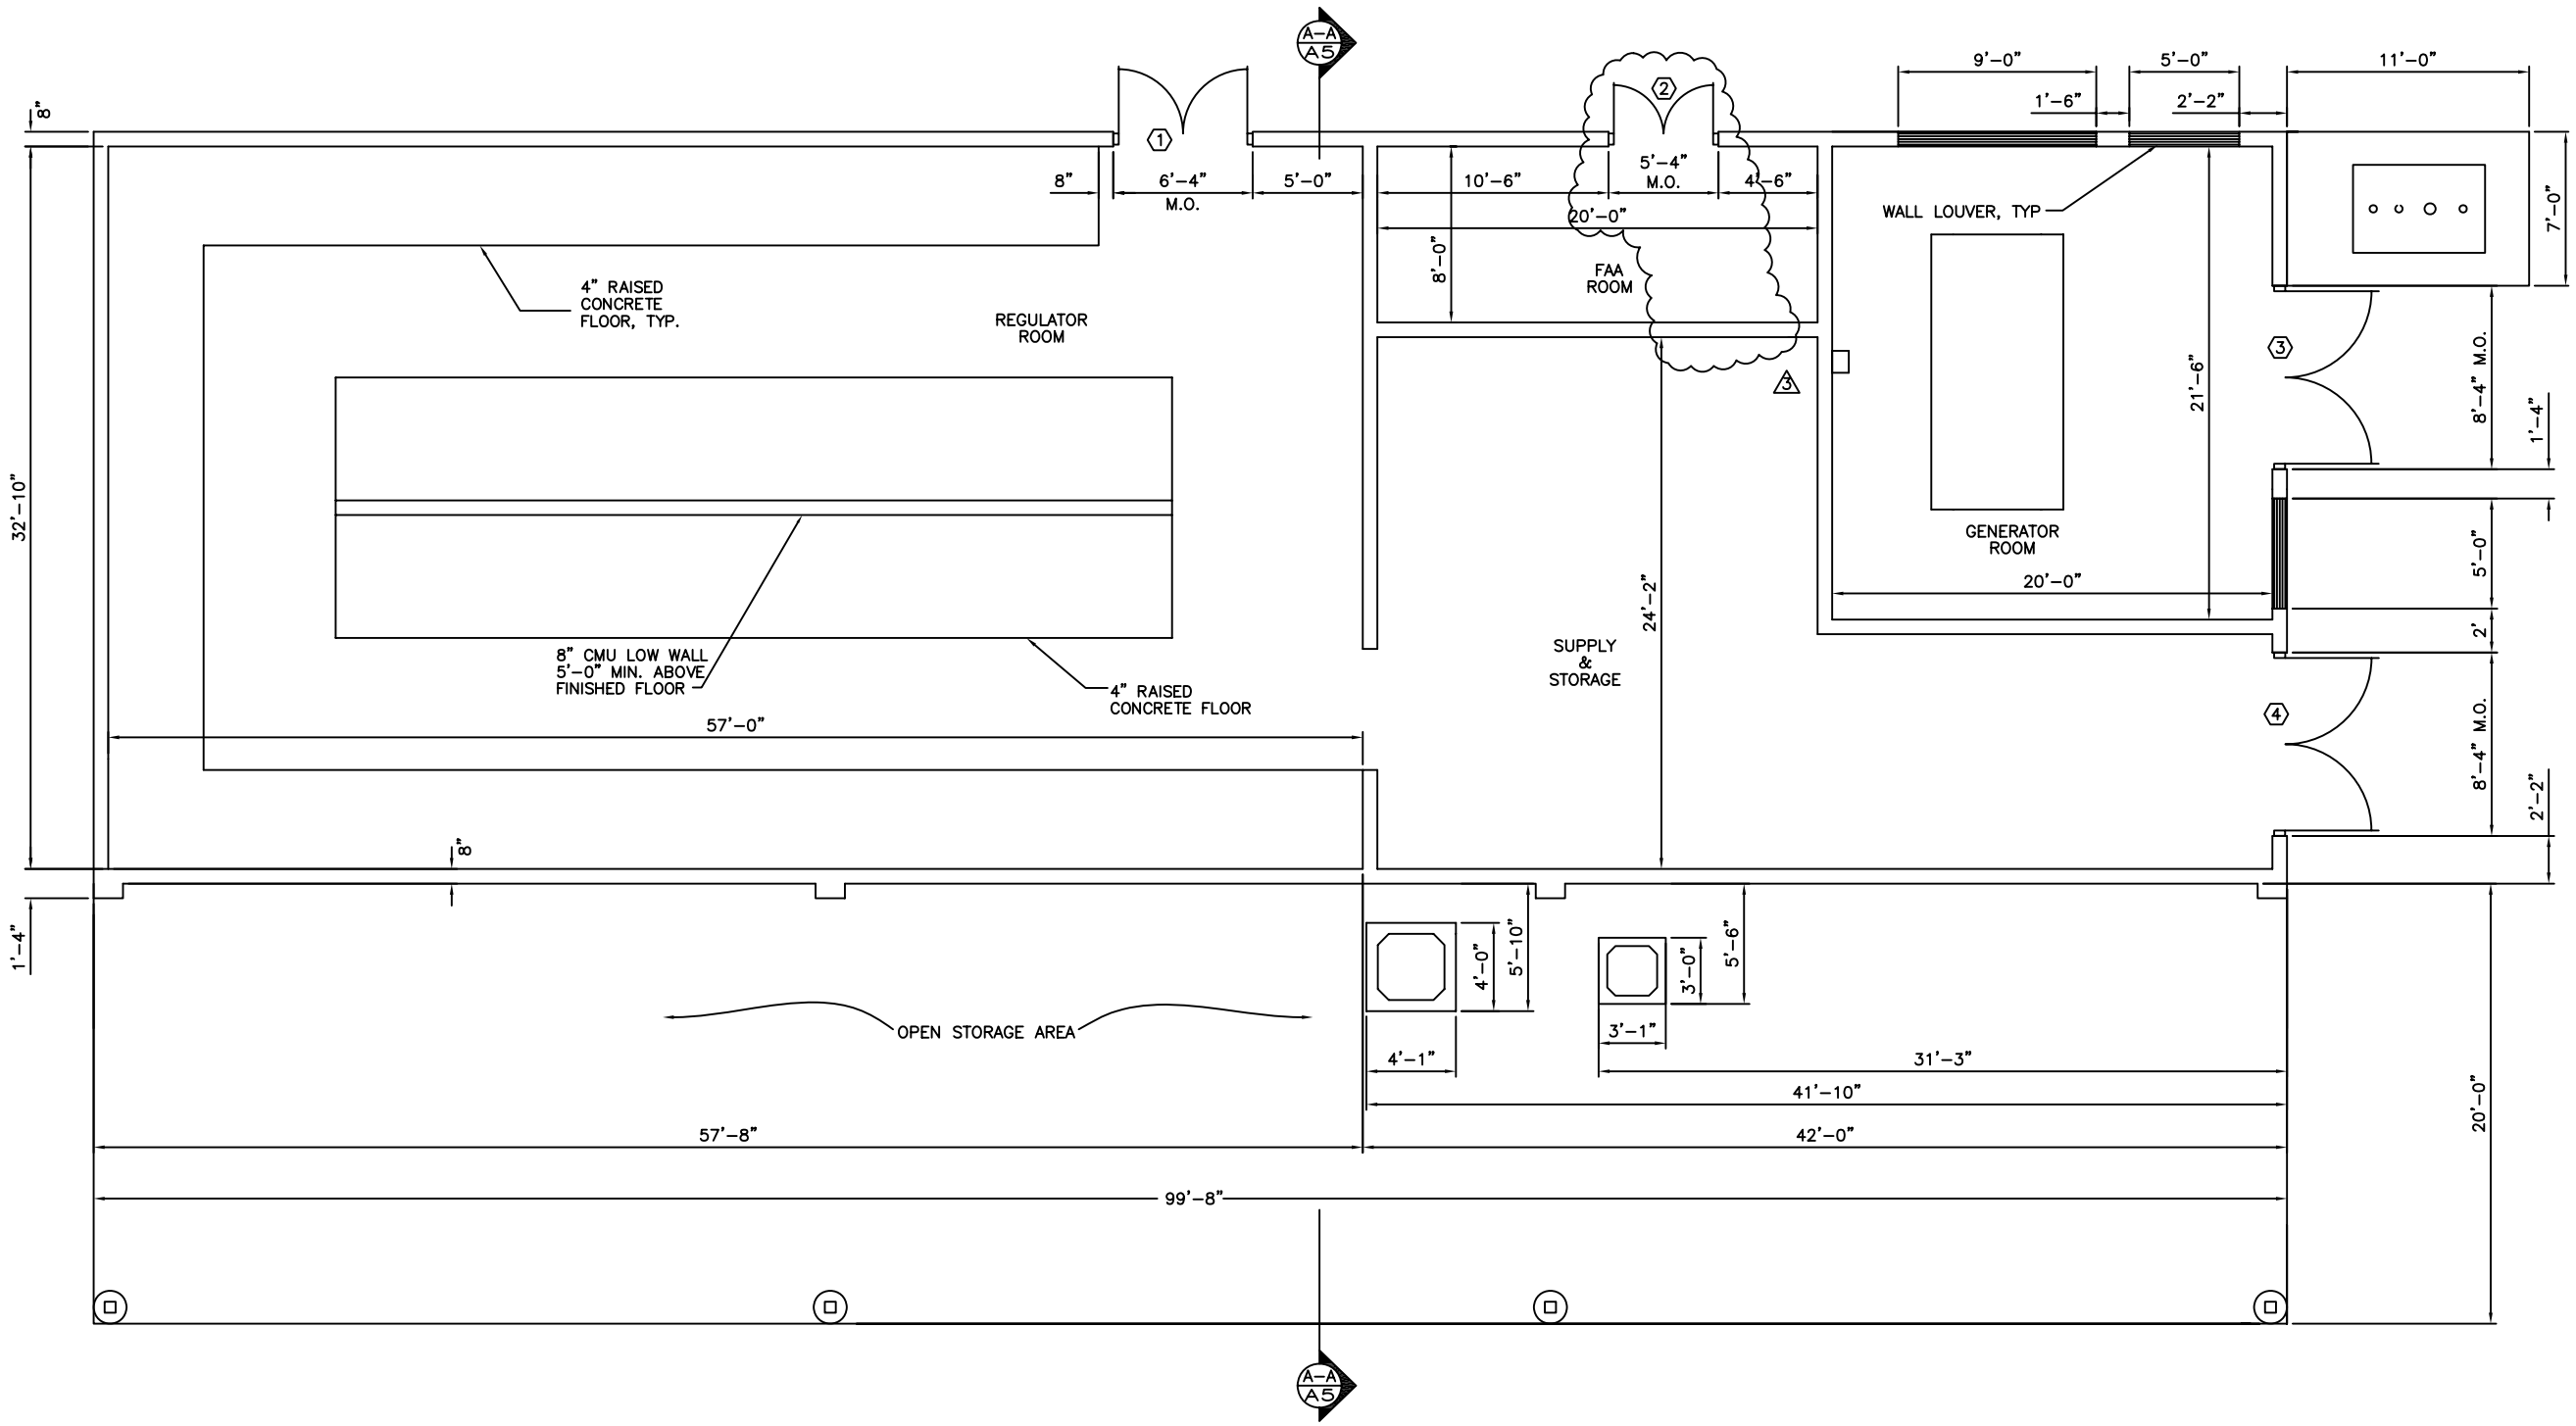

FLOOR PLAN

SCALE: 1/4" = 1'

North

NOTE: GENERATOR ROOM SHALL BE CLOSED OFF FROM REGULATOR ROOM BY RUNNING CMU'S TO BOTTOM OF ROOF DECK AND SEAL OFF WITH CAULKING AND CLOSURE STRIPS FOR AN AIR-TIGHT SEAL.

RECORD DRAWING

THESE "RECORD DRAWINGS" SHOW SIGNIFICANT CHANGES IN THE WORK MADE DURING CONSTRUCTION. THIS INFORMATION PROVIDED BY THE CONTRACTOR VIA "MARKED-UP PRINTS, DRAWINGS AND OTHER DATA" HAS BEEN INCORPORATED INTO THE DRAWING BY THE DESIGNER.

S:\CADD-Files\1-JIA\Archived Drawings\Morgue-CIP-Contracts\C-639 Lighting Vault Reloc_Modern 3-1-02\RECORD DRAWINGS\1002A1.dwg Feb 20, 2008 - 9:36am

JAXPORT
JACKSONVILLE PORT AUTHORITY
JACKSONVILLE, FLORIDA

PROSSER HALLOCK
Planners & Designers
8101 Philips Highway, Suite One
Jacksonville, Florida 32256-7547
p|904.739.3655
f|730.3413 e|prosserhallock.com

AVCON
AVCON, INC.
ENGINEERS & PLANNERS
804 COURTLAND ST. SUITE 200 • ORLANDO, FL 32804-1944
OFFICE (407) 896-1126 • FAX (407) 896-1150

Navigant CONSULTING, INC.

JACKSONVILLE INTERNATIONAL AIRPORT

AIRFIELD LIGHTING VAULT RELOCATION / MODERNIZATION

BUILDING FLOOR PLAN

SCALE: AS NOTED

REVISIONS:

NO.	DATE	BY	DESCRIPTION
1	7/24/00	S.S.	BID SET
2	10/2/00	S.S.	REL. FOR CONST.
3	3/01/02	S.S.	RECORD DRAWING

DESIGNED BY: S.S.
DRAWN BY: K.L.
APPROVED BY: S.S.
DATE: JULY 24, 2000

CONTRACT NO. C-639
JPA PROJECT NO. J-2000-05
F.A.A. AIP NO. 3-12-0035-3400
PROJECT NO. 200010.02

SHEET NUMBER

A1